



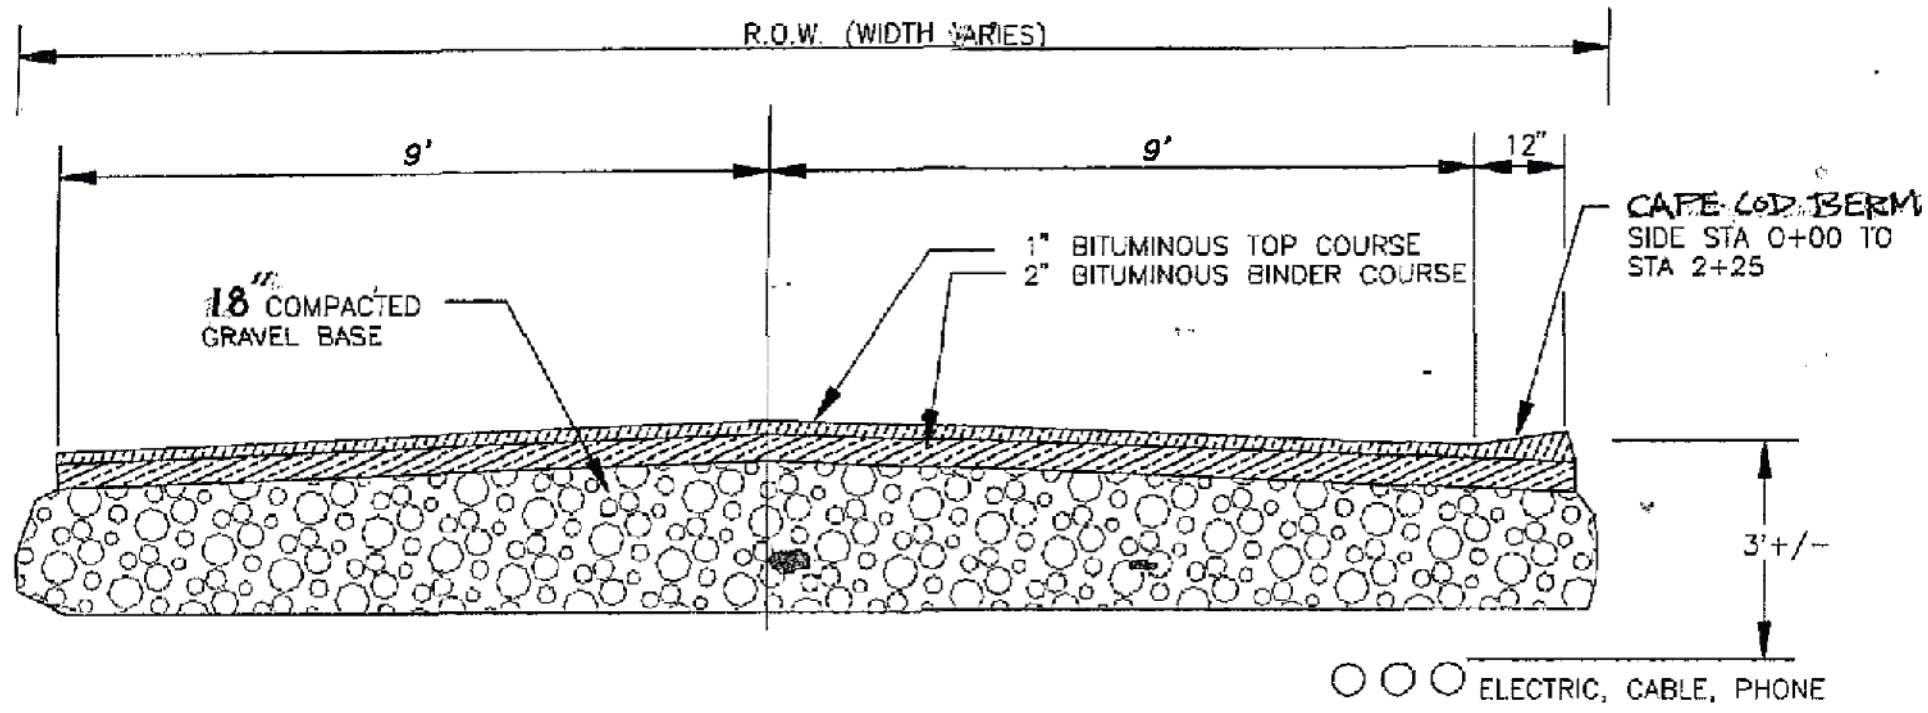


CROSS-SECTION N.T.S.

NOTES

- 1) TOPOGRAPHIC INFORMATION WAS DERIVED BY GRAZ ENGINEERING INSTRUMENT SURVEY. ELEVATIONS BASED ON TOWN DATUM (EXISTING STORM DRAINAGE SYSTEM).
- 2) ALL LOTS ARE TO BE SERVICED BY INDIVIDUAL SUBSURFACE DISPOSAL SYSTEMS AND INDIVIDUAL WATER WELLS.

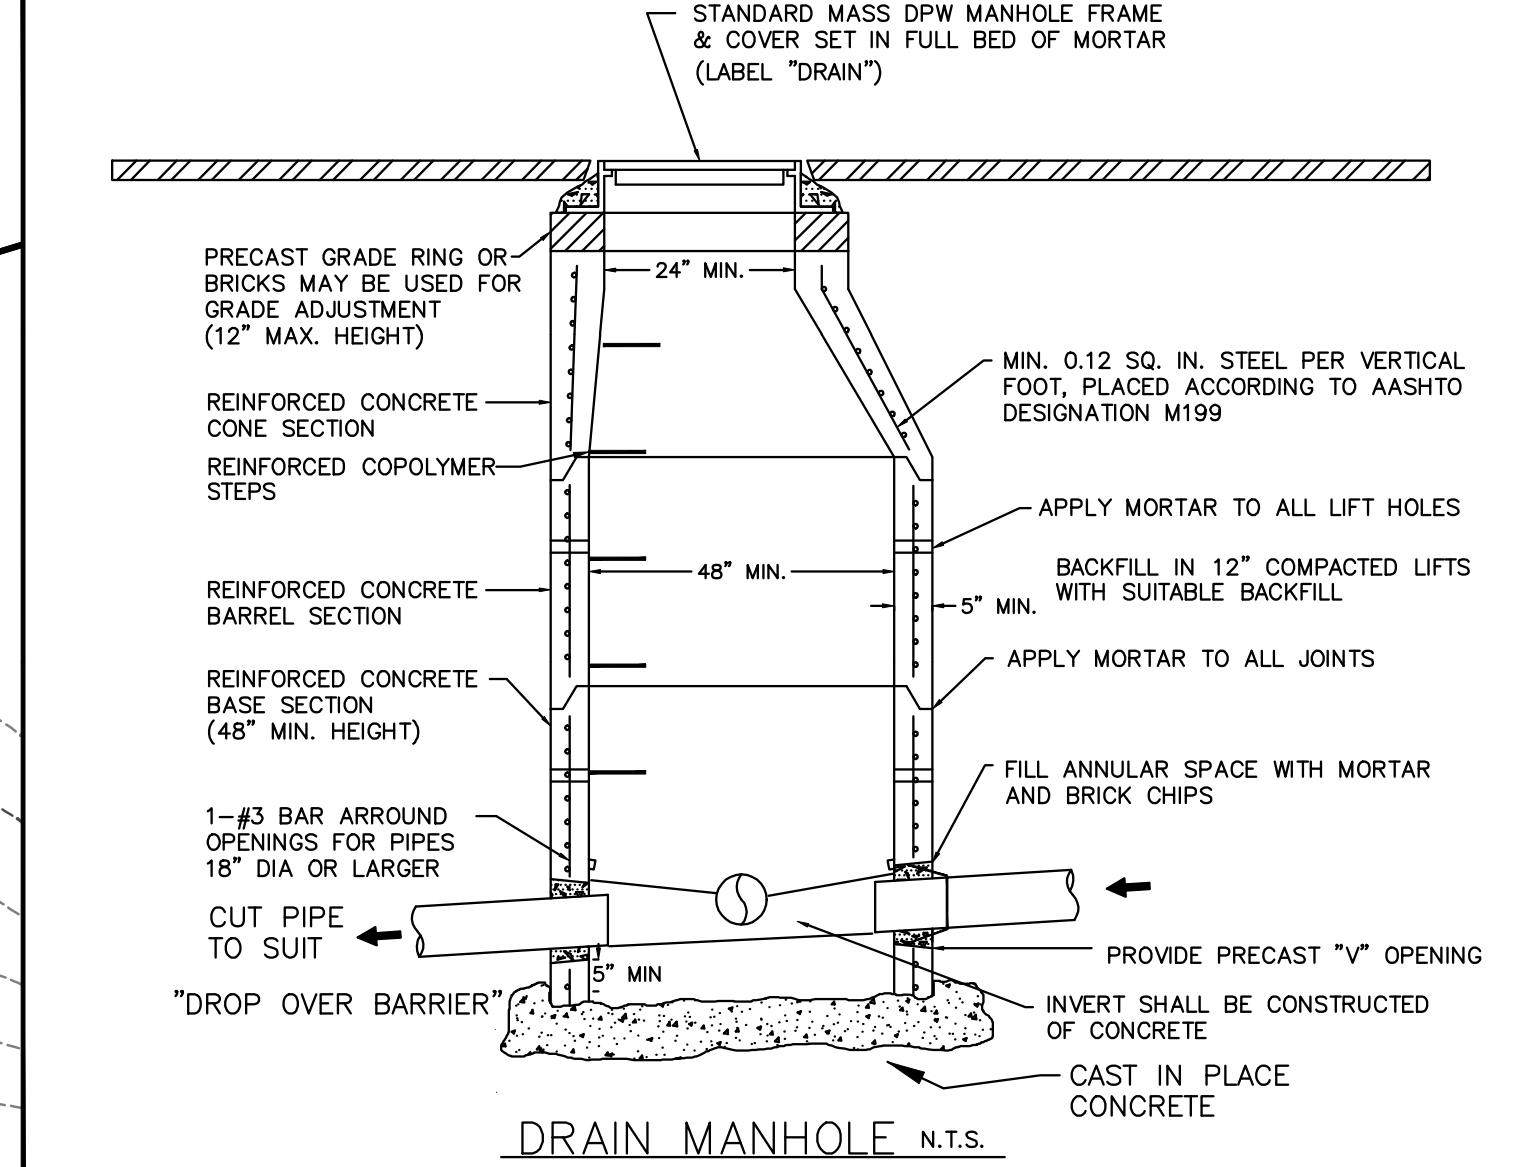

DRAIN MANHOLE N.T.S.

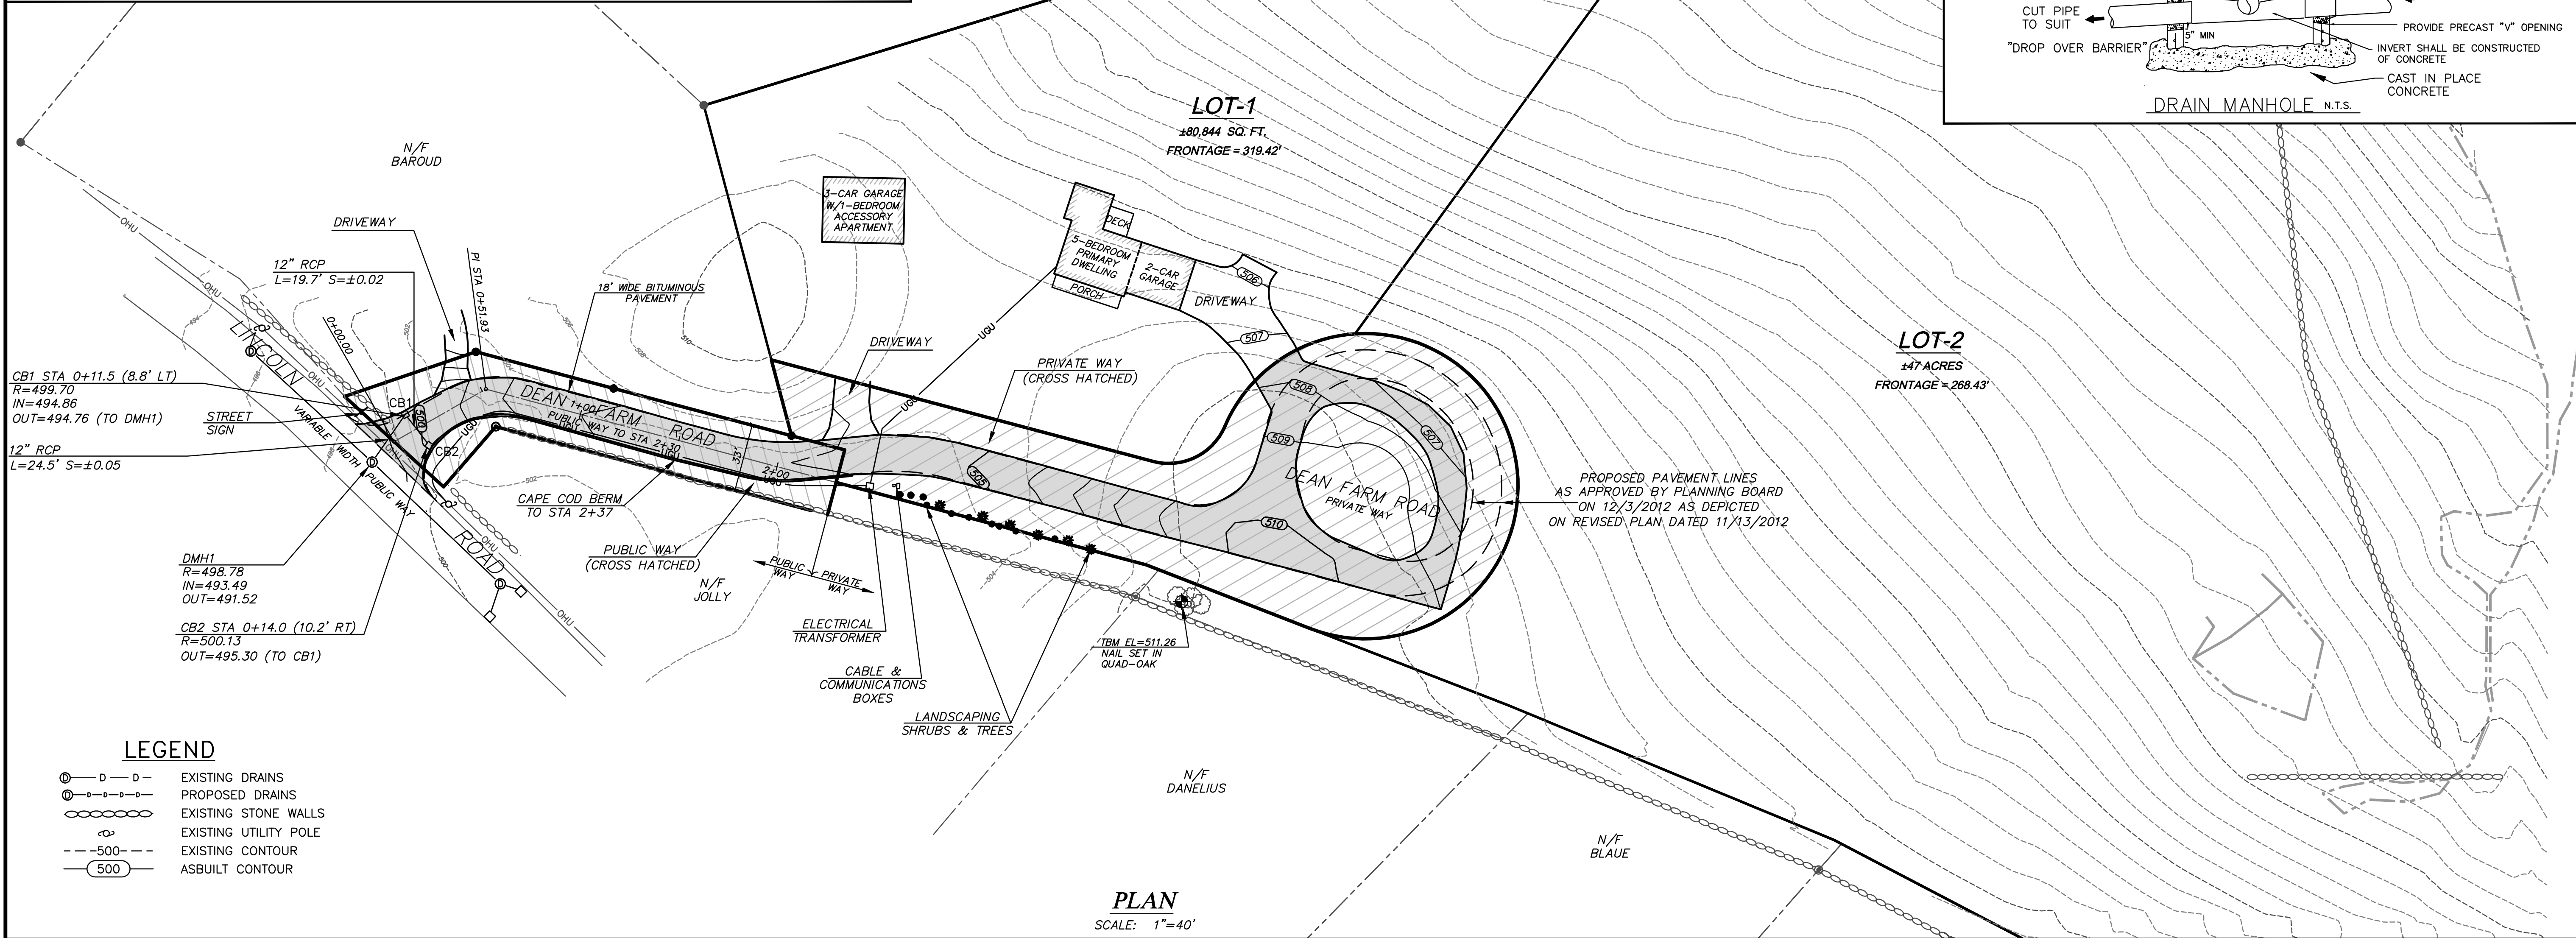


PLAN


SCALE: 1"=40'

LEGEND

- ① — D — D EXISTING DRAINS
- ② — D — D PROPOSED DRAINS
- ○ ○ ○ ○ EXISTING STONE WALLS
- ⊙ EXISTING UTILITY POLE
- - - 500 - - - EXISTING CONTOUR
- 500 ASBUILT CONTOUR

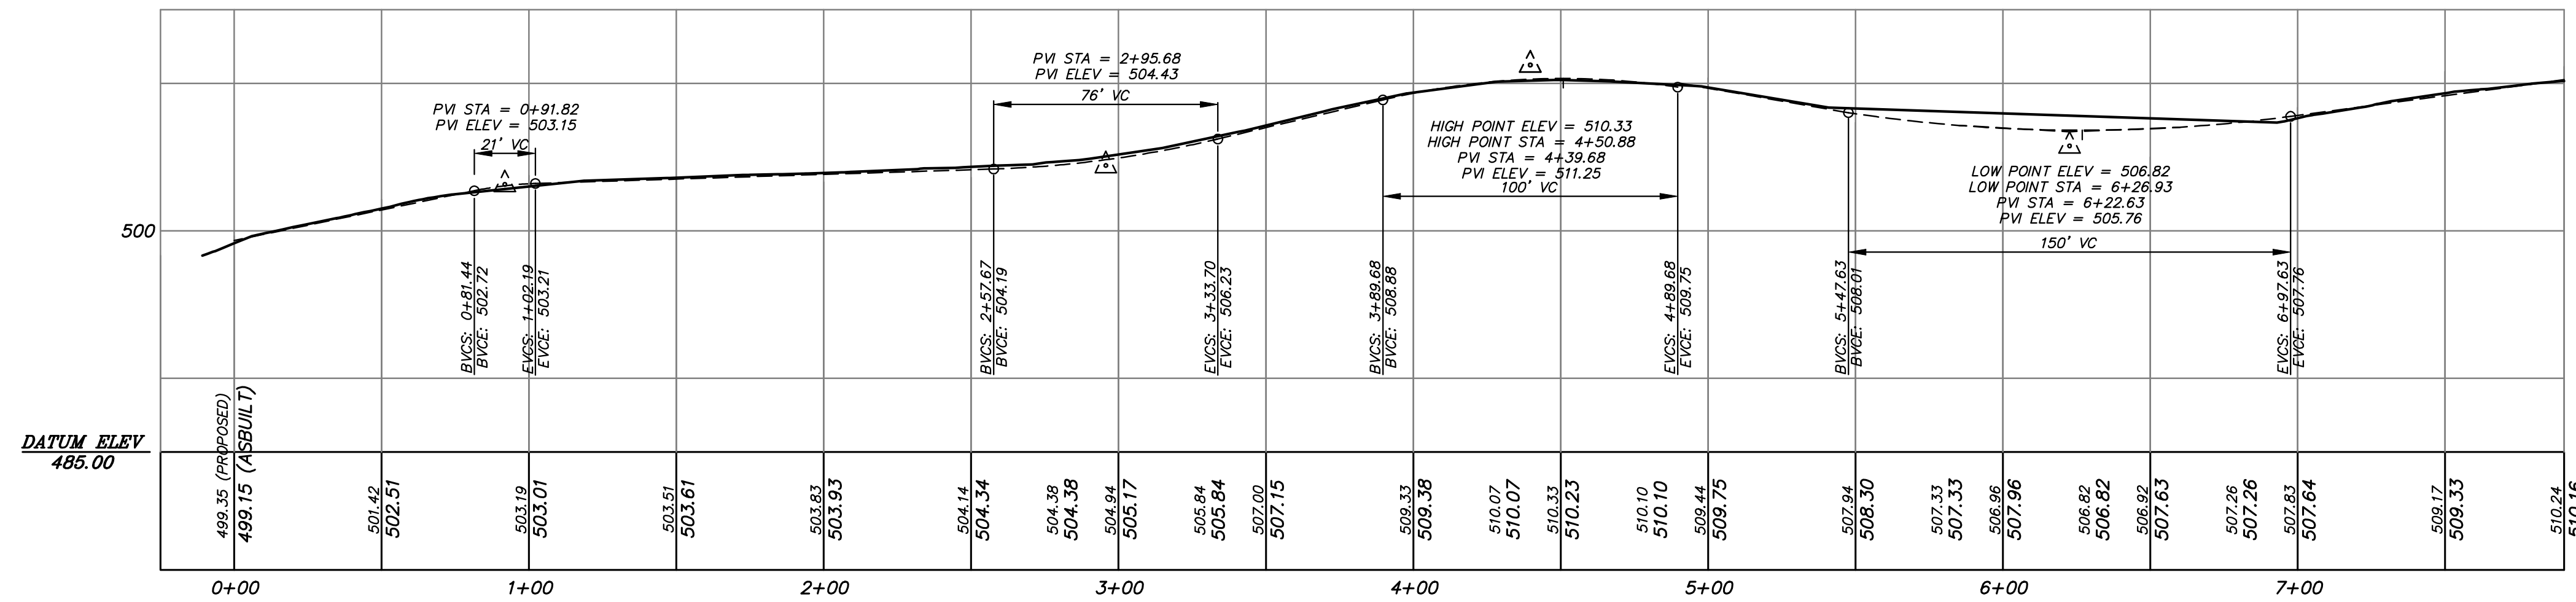

DATUM ELEV
485.00

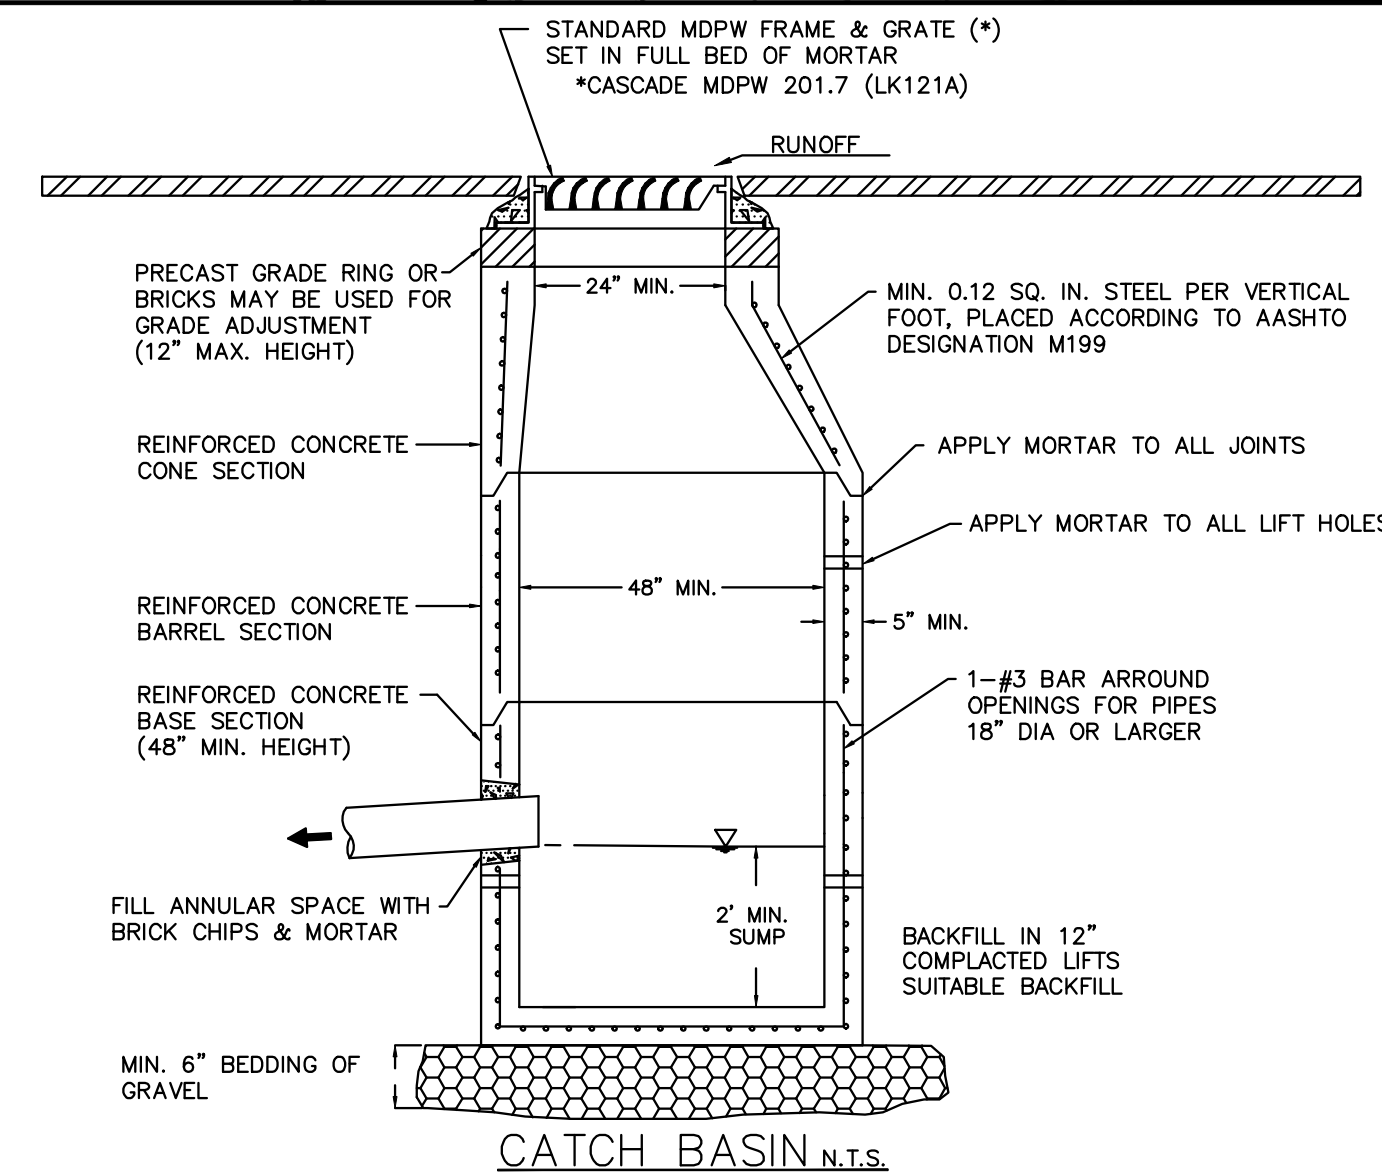

CATCH BASIN N.T.S.

GRAZ Engineering, L.L.C.

323 West Lake Road, Fitzwilliam, NH 03447
Phone: (603) 585-6959 Fax: (603) 585-6960

DEFINITIVE SUBDIVISION - DEAN FARM ROAD COMMON DRIVE
SUTTON, MASSACHUSETTS

ASBUILT ROADWAY LAYOUT PLAN
PREPARED FOR: DAVE MASON
65 DEPOT STREET, SOUTH GRAFTON, MA 01560

SCALE	AS-NOTED	DRAWN BY	DATE	DESCRIPTION	BY
		BCM			

