
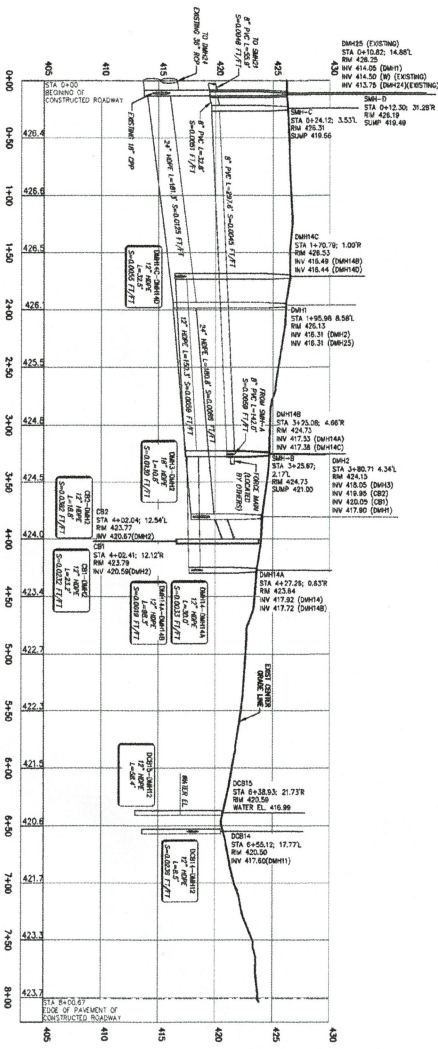


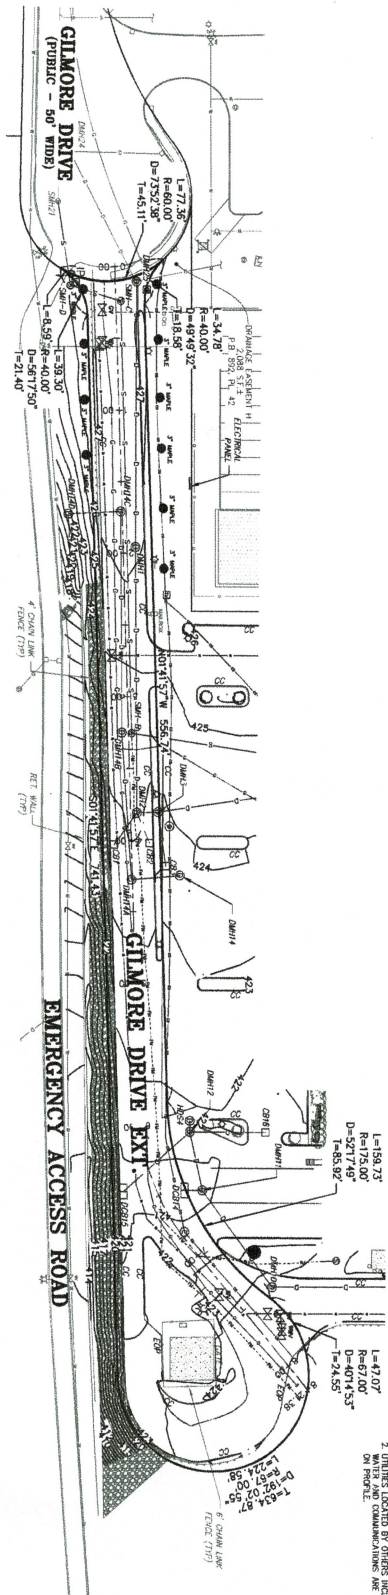

- NOTES:
1. LOCATIONS OF EXISTING UTILITIES SHOWN ON THIS DRAWING ARE A RESULT OF FIELD INVESTIGATIONS. WATER, COMMUNICATIONS, ELECTRIC AND SEWER UTILITIES NOT SHOWN AND IT SHALL BE THE RESPONSIBILITY OF THE CONTRACTOR TO VERIFY THE LOCATION OF ANY UTILITIES PRIOR TO COMMENCEMENT OF ANY CONSTRUCTION. WORKING POINTS IN ADVANCE OF CONSTRUCTION. WATER AND COMMUNICATIONS ARE NOT SHOWN IN THIS PLAN.
 2. UTILITIES LOCATED BY OTHERS INCLUDING GAS, WATER AND COMMUNICATIONS ARE NOT SHOWN IN THIS PLAN.

ASE
 Anderson Survey & Engineering, Inc.
 Land Surveying - Civil Engineering - Site Planning
 170 Main St., 1st Floor
 Maynard, MA 01754
 Tel: 978-534-1100
 Fax: 978-534-1101
 www.ase-engineering.com

LEGEND

SEWER MANHOLE (AS-BUILT)	□
CATCH BASIN (AS-BUILT)	□
DOUBLE CATCH BASIN (AS-BUILT)	□
DEBRIS MANHOLE (AS-BUILT)	□
FLARED END SECTION (AS-BUILT)	□
MAN-BOSS	□
LIGHT POLE	□
AS-BUILT CONTOURS	—
COMMUNICATION LINE (LOCATED BY OTHERS)	—
GAS LINE (LOCATED BY OTHERS)	—
WATER LINE (LOCATED BY OTHERS)	—
FORCE MAIN (LOCATED BY OTHERS)	—

PROJECT:
 PRIMETALS TECHNOLOGIES
 85 GILMORE DRIVE
 SUTTON, MA 01590

APPLICANT:
 J.M. COULL, INC.
 20 POWDER MILL ROAD
 MAYNARD, MA 01754

REVISIONS

NO.	DATE	DESCRIPTION
1	6/14/20	ISSUED FOR PERMIT

GRAPHIC SCALE

1" = 40' HORIZONTAL
 1" = 4' VERTICAL

SHEET TITLE
 GILMORE DRIVE
 EXTENSION
 CONSTRUCTION
 RECORD PLAN

CRD
 DES: BT, AS | DATE: 07/15/2020
 CHK: BT, AS | PROJECT NO.: 2018-369
 F:\2018\2018-369

Rev
 8/14/20