

**Sutton Planning Board
Approval Not Required Checklist**

Location: 12 John / 16 RWP TPR
(2 page plan)

Requirements:

- ☒ All taxes paid

Filing

- ☒ Filled in completely
☒ Signed by applicant and owner (if different)
☒ Fee Submitted - \$100 per lot changed or created: \$200
☐ Original mylar plan ☐ Three copies ☒ pdf via email

Plan Contents

- ☒ Title ☒ North point ☒ Date: 10-22-21 ☒ Scale 1" = 20' : 1" = 80'

- ☒ Locus plan showing relationship of proposed lot(s) to surrounding ways and parcels. (Please do not "zoom out" too far from parcel)

- ☒ Signature block for Members of the Board

- ☒ Name and address of owner of record for property:

- ☒ Current abutter's names, including those directly across a way

- ☒ Name, address and stamp of Registered Professional Land Surveyor who prepared plan *on final*

- ☒ Assessor Map/Lot 4/27? 4/51 ☒ Deed Book and Page multiple

- ☒ Frontage of proposed lots, reconfigured lots, any remaining adjoining land owned in whole or in part by the applicant shall be shown

- Please note frontage cannot be "illusionary" you must be able to actually get from the roadway on which the lot has frontage to where building will occur without unreasonable alterations or machinations. IE: 100' long bridge, mountain goat and sherpa, etc.
- Abutting non-conforming lots in the same ownership/financial interest are considered merged under the Doctrine of Merger and cannot be divided unless the resulting new lots are conforming to the current standards.

- ☒ Sufficient data to determine: Width & Condition (to indicate safe and Adequate access), and Status lot frontage *shown - public*

Provide for each lot or parcel and/or remainder thereof:

- ☒ Zoning classification and requirements, including overlay districts

- ☒ Lot line dimensions, bearings and distances

Add Note that 100' frontage with a width of 125' is allowed on a cul-de-sac

Location: 12 John & 16 RWP Trlke (2 page plan)

☒ Total area in square feet and acres of all lots shown

☒ Width as determined by the Zoning Bylaw – Show this on plan dotted line with measurement – for retreat lot show minimum lot width with dotted line wherever it exists. (has to be at least 50') *width still isn't shown? Lot 2 appears to be non-compliant → has to be @ least 125'*

☒ Flood plains and zones & wetlands and resource areas pursuant to the Wetlands Protection Act and Riverway Protection Act from the frontage of the lot and encompassing a contiguous area until the upland requirement is met – Indicate when wetlands were flagged and by whom.

☒ Uplands determination as defined by the Zoning Bylaw (60% of required lot area must be contiguous upland that can be accessed from the legal frontage of the lot)

I don't see note for lot 1?

☒ Regularity factor as defined by the Zoning Bylaw
($16 \times \text{Area in s.f.} / \text{Perimeter in s.f.}^2 : 16A/P^2$)


☒ Location and description of all existing buildings and structures, septic systems and wells.

☒ Location and description of all easements and/or encumbrances, including their square footage. These areas may not be included in required lot area. -

☒ All parcels considered non-buildable shall be appropriately indicated

General Notes:

width line example :

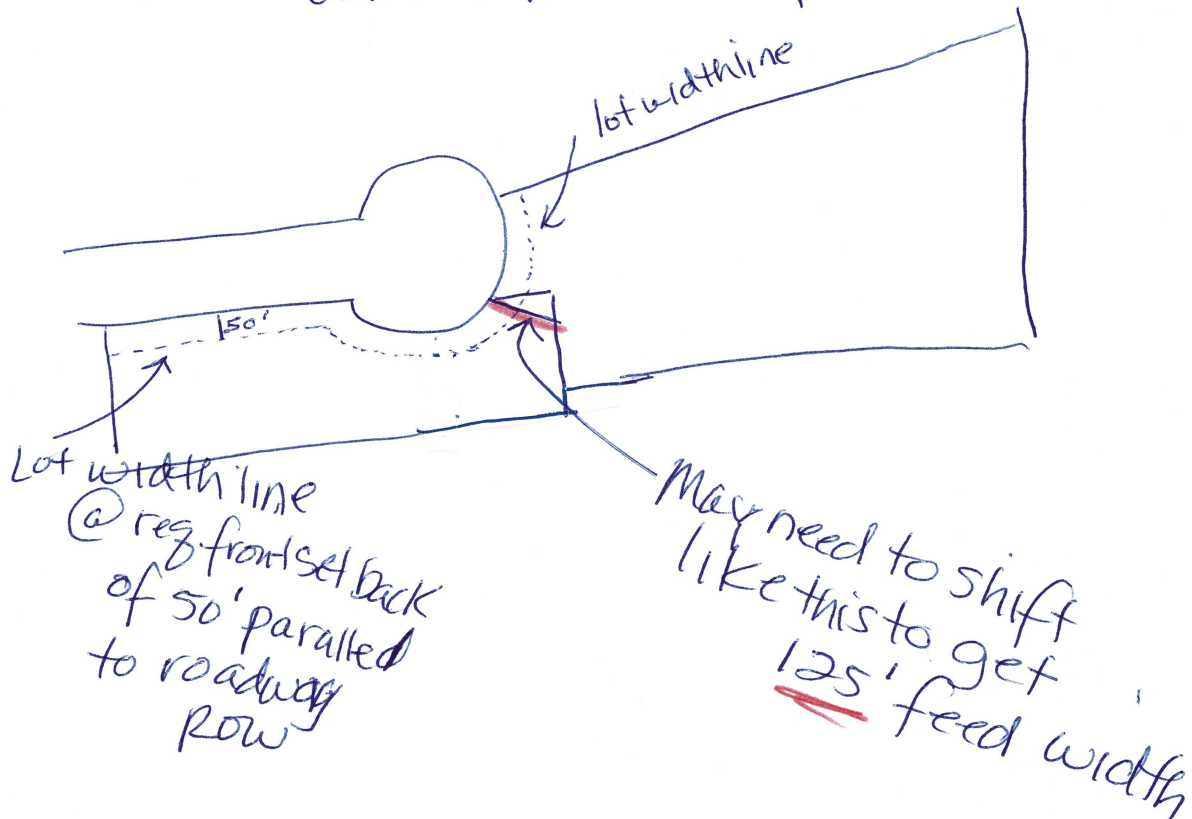

Michael Gagan, Chair
William Talcott, Vice-Chair
Robert S. Largess, Jr.
Scott Paul
Walter A. Baker

Jennifer S. Hager,
Planning & Economic Development Director



Sutton Town Hall
4 Uxbridge Road
Sutton, Massachusetts 01590
Telephone: (508) 865-8729
www.suttonma.org

TOWN OF SUTTON PLANNING BOARD & DEPARTMENT

Payment of Taxes

The following entity: MIG Corp. has an application before the Planning Board relative to property located at 12 John Road and 16R Worcester Providence Turnpike

Map: 4

Parcel: 27 & 51

Please advise if any taxes are outstanding under these name at these locations.

Please provide information ASAP. Thank you!

The above party _____ Does Does Not currently owe any taxes to the Town of Sutton.

Delinquent taxes are owned on the following property & time period:

Next due on both parcels is on Feb. 1, 2022

Signed: Yusef Lynch, Tax Collector's Office Date: 1/6/2022